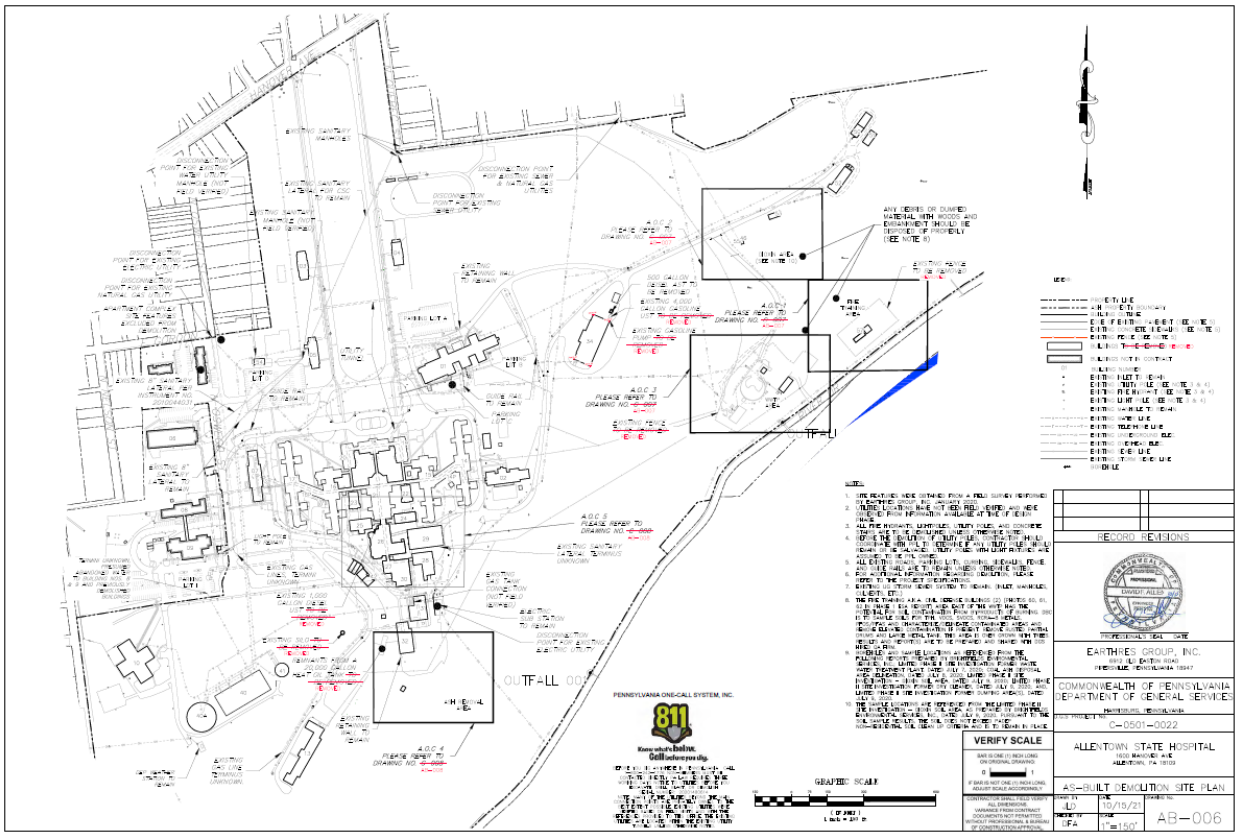Attachment Lii. – As-Built Plans from Demolition